

FACSIMILE



Site ID: 36460 entered as 'U' 20/11/01
 Site ID: 36468 entered as 'U' 21/11/01

sch4p4(6) Personal information

TO	EPA	DATE	18/11/01	Brisbane City Council Pollution Prevention Health & Safety Branch Level 4 89 Ann Street BRISBANE Q 4000 GPO Box 1434 BRISBANE Q 4001 Ph: 3403 4721 Fax: 3403 9580
ATTENTION	Tess Dobinson	FAX	3247 3278	
FROM	Jamie Simmonds Potemp2@brisbane.qld.gov.au	PHONE	3403 5584	
SUBJECT	7 Chester St., Newstead L.100-103/RP.9281	PAGES	4	

Dear Tess,

Council is informing your department that a review of the above sites has found notifiable activity - **Petroleum Product or Oil Storage**. Council notified the EPA regarding these sites on 20/6/94.

All 4 of the above sites are currently owned by Cyril Smith Funerals Pty. Ltd. This company was first granted an F&C licence in 1952 for storage of flammable liquids that was well below notifiable levels. The first notifiable F&C activity occurred in 1979 when they were granted approval to install one 2,200L underground tank for Motor Spirits. The location of this tank was on L.103/RP.9281 (see attached site map and Bimap).

This tank was in service until 1987 when it was sand abandoned. A new 5,400L underground tank for Motor Spirits was installed on L.101/RP.9281 that same year (see attached site map and Bimap). The premises still holds an F&C licence for this underground tank.

No further notifiable activity was found on these sites.

If you require any further information, feel free to contact me at the above number.

Regards,

sch4p4(6) Personal information

Jamie Simmonds
 Project Officer, Environmental Protection




current on CISP → ① Please send 373(u) Notice for L101/RP9281 & L103/RP9281 for N.A. 29-petroleum product or oil storage.
 ② Pass to Anemerie to update

Owner Details
 Cyril Smith Funerals Pty Ltd
 P.O. BOX 2170
 Fortitude Valley Qld
 4006

Our Business - A Better Brisbane

BCC spreadsheet / queries d/base.

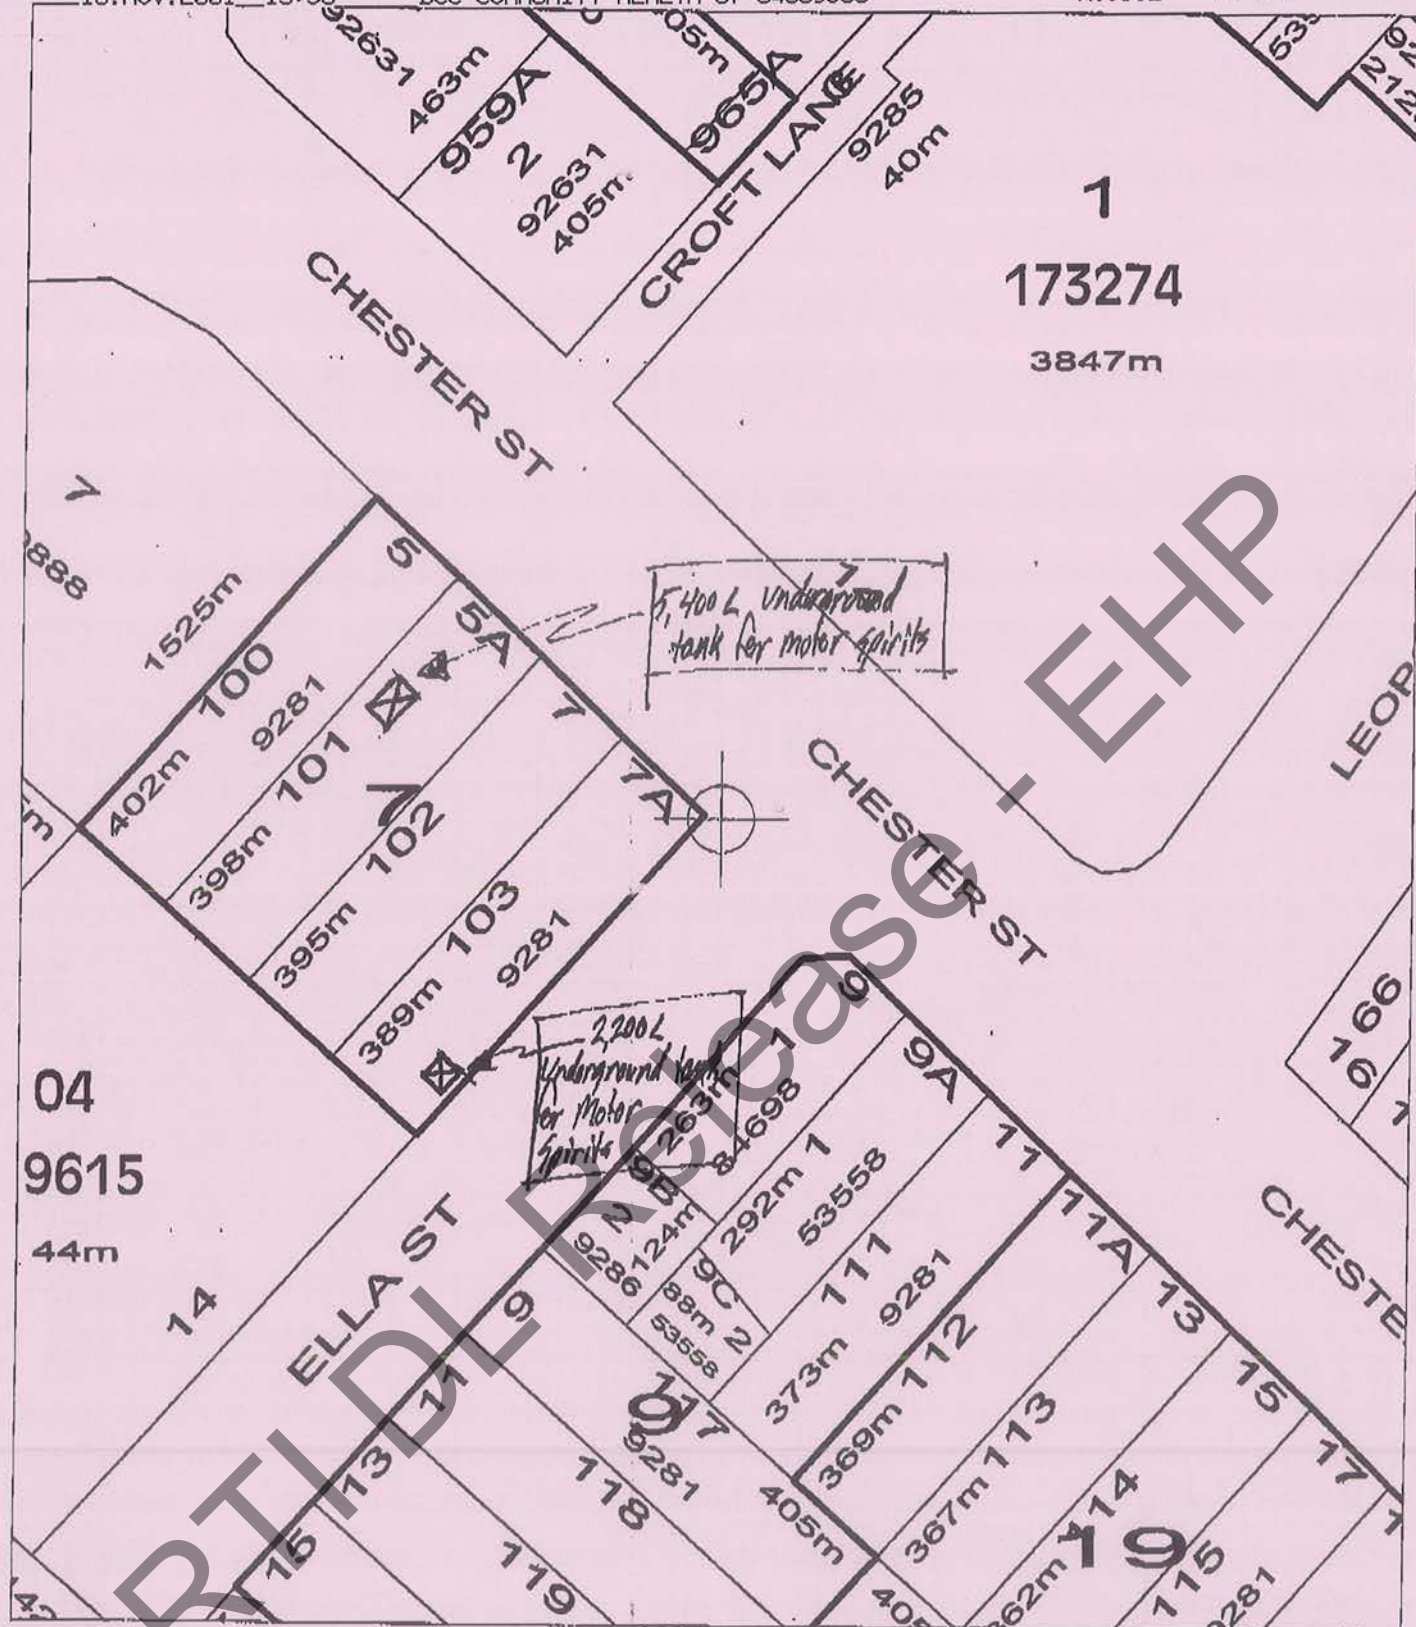

Copyright ©CC, 2001
webBSE versien 1.12

Date: 16/11/2001
Time: 11:20:50
Userid: potemp2
Scale: 1:625
Location:
504008 6963266


Themes:
Cadastre
Property Holdings

Disclaimer:

"While every care is taken by Brisbane City Council (BCC) and Dept. of Natural Resources & Mines (NRM) to ensure accuracy of this data, BCC and NRM jointly and severally make no representations or warranties about its accuracy, reliability, completeness or suitability for any particular purpose and disclaim all responsibility and all liability (including without limitation, liability in negligence) for all expenses, losses, damages (including indirect or consequential damage) and costs which may be incurred as a result of data being inaccurate in any way and for any reason."

Based on Data provided with the permission of NRM: Cadastral Data (January 2001).



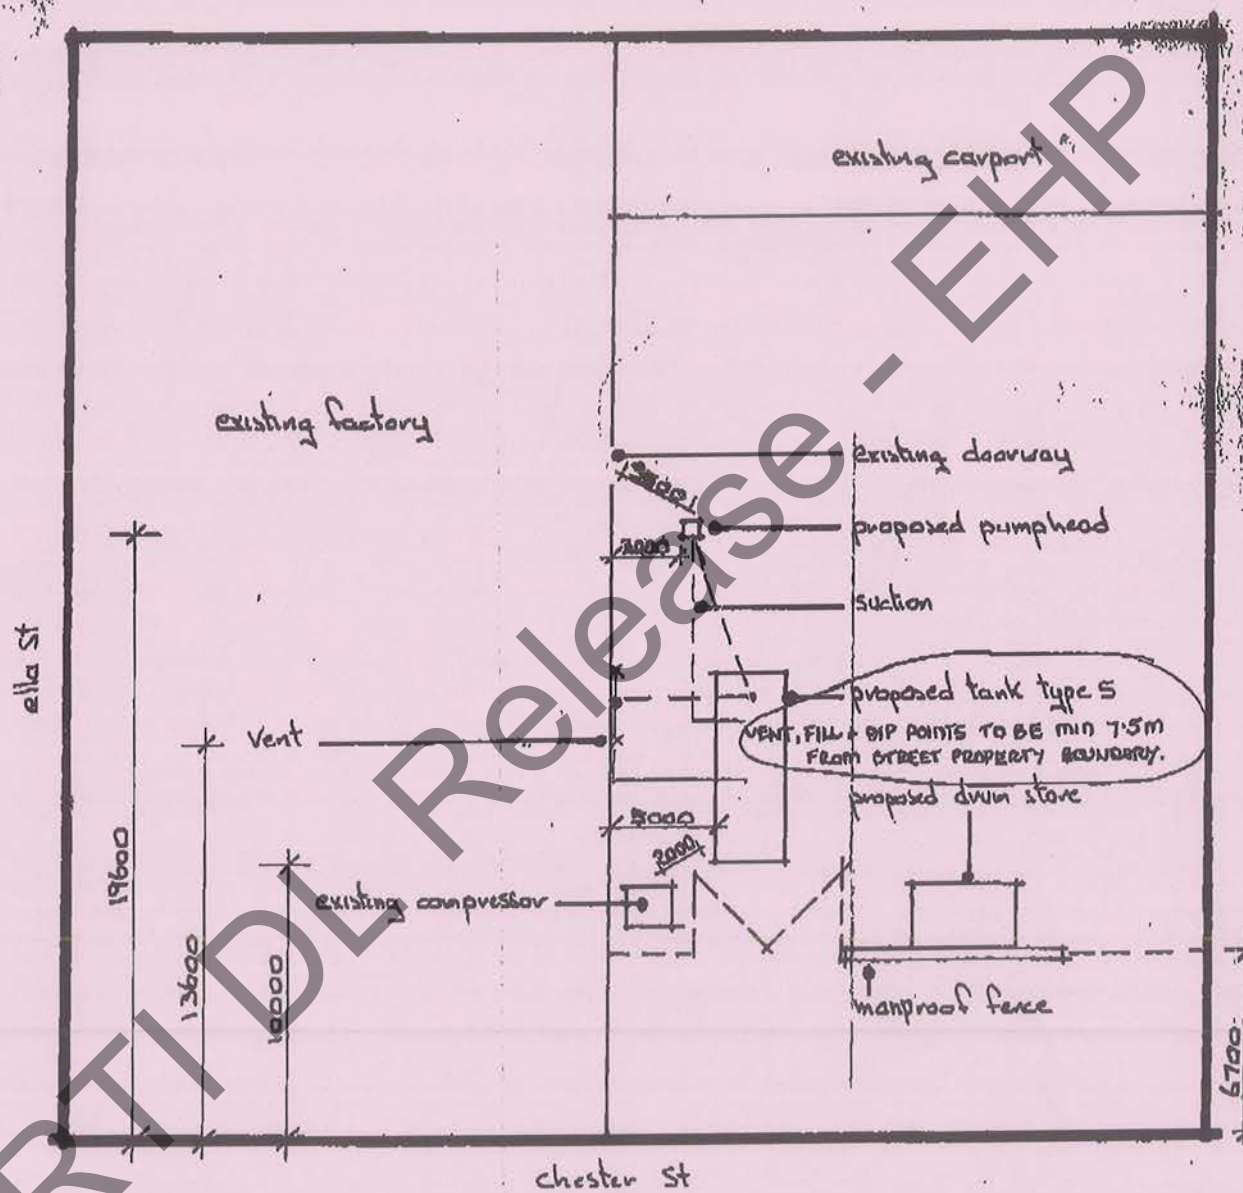

Proposed underground Type S fuel tank and pumphead

Chester St

AMOCO SERVICE ST

25m concrete from road
x 25mm hose

DOOR

VACANT LAND

* Ext
Class B
gl.
25mm Hose

* Ext
Class A
gl.

Ext.
Class A
gl.

* Ext
Mobile
Class B+C
gl.

DOOR

Flammable liquid store
clay brick, concrete roof
metal clad fireboard door
100mm high bunding.

20m

2.9m

Tank 2275l cap.
Dimens 1.5m x 1.5m x 1m
0.9m below surface
0.7m sand 0.2m concrete

x 25mm
100mm
6m x
Ext
Class B+C
2 gals gl.

Dip

1.7m

20m

DOOR

2.2m Vent: 15m above 114p

Top high; 3 above roof Foot bath

Fill Point

Ella St.

K. M. SMITH - Chester + Ella Sts Valley.
Lots 100/103 ESA 56 Pos Nth Brisbane

Release - E